

THIS DRAWING IS UNPUBLISHED.

RELEASED FOR PUBLICATION

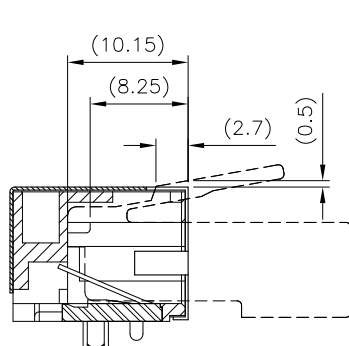
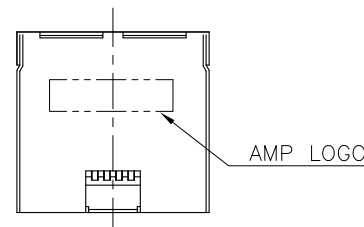
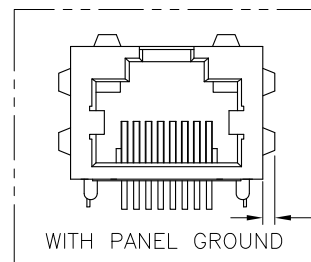
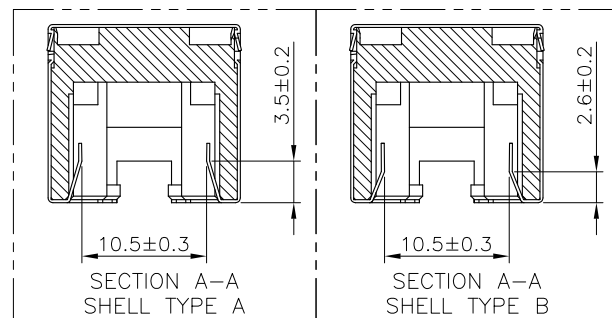
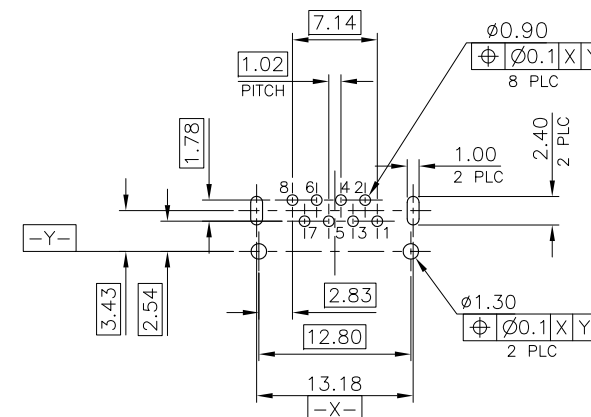
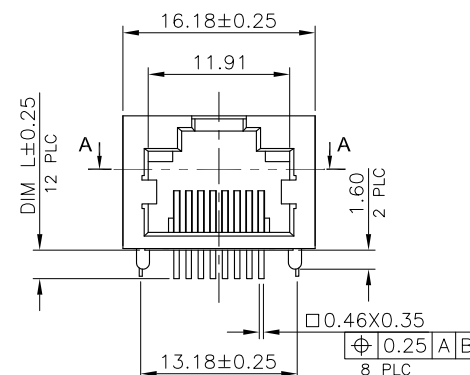
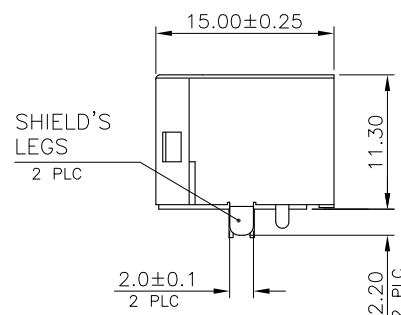
© COPYRIGHT 2010 BY TYCO ELECTRONICS CORPORATION. ALL RIGHTS RESERVED.

LOC
DW

DIST

REVISIONS

P	LTR	DESCRIPTION	DATE	DWN	APVD
E		REVISED (ECR-12-012115) OBSOLETE PNS: -3, -8, -13, -14, -16 & -17	26OCT'12	E.L.	W.K.

MATING WITH RJ-45 PLUG
(REFERENCE)RECOMMENDED PCB LAYOUT (THICKNESS: 1.6MM)
(DIMENSION TOLERANCE: 1 PLC: ±0.1, 2 PLC: ±0.05)

NOTE:

1. MATERIAL:

1.1 HOUSING: PA9T WITH 30% GF, UL94 V-0, BLACK COLOR.

1.2 CONTACTS: PHOSPHOR BRONZE.

1.3 SHELL: BRASS.

2. FINISH:

2.1 CONTACTS:

(SEE TABLE) GOLD PLATED ON CONTACT AREA.

GOLD FLASH ON SOLDER TAIL.

1.27µm [50u"] MIN. NICKEL UNDERPLATED OVERALL.

2.2 SHELL: 0.51µm [20u"] MIN. NICKEL PLATED.

3. WAVE SOLDER CAPABLE TO 265°C PER TYCO TEST SPEC. 109-202, CONDITION B.

4. OBSOLETE PART : OBSOLETE CIS STREAMLINING PER D.RENAUD/D.SINISI

THIS DRAWING IS A CONTROLLED DOCUMENT.

DIMENSIONS: mm	TOLERANCES UNLESS OTHERWISE SPECIFIED:
0 PLC	± .
1 PLC	± 0.3
2 PLC	± 0.2
3 PLC	± 0.15
4 PLC	± .
ANGLES	± 3°
MATERIAL SEE NOTE	FINISH SEE NOTE

DWN O. HU	14SEP2007
CHK S. HOU	14SEP2007
APVD W.J. KE	14SEP2007
PRODUCT SPEC	108-57535
APPLICATION SPEC	
WEIGHT	3.5 GRAMS
CUSTOMER DRAWING	

	TAPE & REEL	W/O	W/O	TYPE A	2.2	6u"	3-1734795-2
					1.5	6u"	3-1734795-1
TE	TRAY	W/ W/O			2.4	50u"	~~1734795-8~~
						30u"	1734795-7
						15u"	1734795-6
				6u"		1734795-5	
				50u"		1734795-4	
TE	W/O	TYPE B		30u"	~~1734795-3~~		
TE		TYPE A		15u"	~~1734795-2~~		
				6u"	1734795-1		
	PACKAGE TYPE	PANEL GROUND	LED	SHELL TYPE	DIM L	MIN. GOLD THICKNESS	PART NUMBER

STE

TE Connectivity

NAME				MODULAR JACK CONNECTOR RJ45, 8P8C, SHIELDED TAB UP, DIP TYPE, H=11.3mm	
SIZE	CAGE CODE	DRAWING NO	RESTRICTED TO		
A3	00779	C=1734795			
SCALE			SHEET	REV	
			1 OF 5	E	

THIS DRAWING IS UNPUBLISHED.

RELEASED FOR PUBLICATION



© COPYRIGHT 2010 BY TYCO ELECTRONICS CORPORATION. ALL RIGHTS RESERVED.

LOC
DW




DIST

REVISIONS

P	LTR	DESCRIPTION	DATE	DWN	APVD
		SEE SHEET 1.			

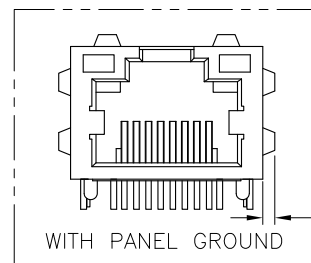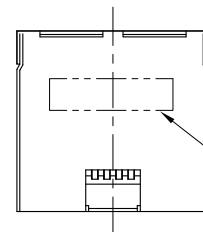0.8~2.0
6 PLC

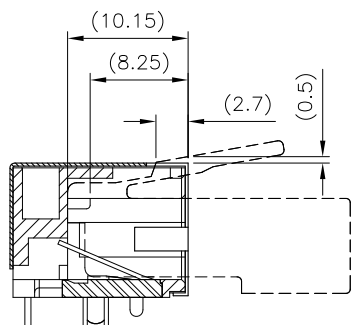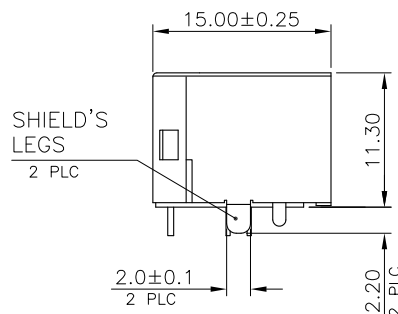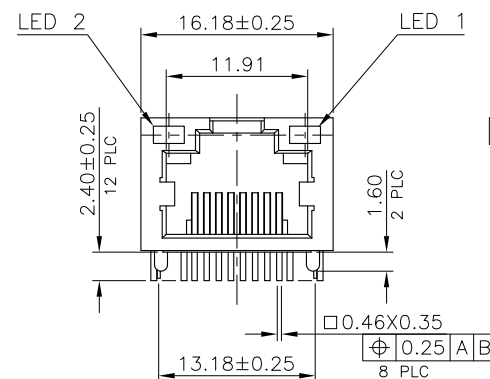AMP LOGO

MATING WITH RJ-45 PLUG
(REFERENCE)SHIELD'S
LEGS
2 PLCLED 2
2.40±0.25
12 PLCLED 1
1.60
2 PLC

0.46X0.35

Ø0.25 A B
8 PLC

13.18±0.25

1.78

1.02

PITCH

Ø0.90

12 PLC

1.00

2 PLC

2.40

2 PLC

Ø1.30

Ø0.1X Y
2 PLC

13.18

-X-

12.80

2.83

3.43

2.54

9.14

-Y-

RECOMMENDED PCB LAYOUT (THICKNESS: 1.6MM)
(DIMENSION TOLERANCE: 1 PLC: ±0.1, 2 PLC: ±0.05)

NOTE:

1. MATERIAL:

- 1.1 HOUSING: PA9T WITH 30% GF, UL94 V-0, BLACK COLOR.
- 1.2 CONTACTS: PHOSPHOR BRONZE.
- 1.3 SHELL: BRASS.
- 1.4 LED LIGHT: EPOXY RESIN & STEEL

2. FINISH:

2.1 CONTACTS:

(SEE TABLE) GOLD PLATED ON CONTACT AREA.
GOLD FLASH ON SOLDER TAIL.

1.27µm [50u"] MIN. NICKEL UNDERPLATED OVERALL.

2.2 SHELL: 0.51µm [20u"] MIN. NICKEL PLATED.

2.3 LED: 1.02µm [40u"] COPPER UNDERPLATED OVERALL.

1.27µm [50u"] NICKEL OVERALL.

1.27µm [50u"] SILVER ON BONDING AREA.

2.54µm [100u"] BRIGHT-TIN ON SOLDER AREA.

3. WAVE SOLDER CAPABLE TO 265°C PER TYCO TEST SPEC. 109-202, CONDITION B.

△ OBSOLETE PART : OBSOLETE CIS STREAMLINING PER D.RENAUD/D.SINISI

THIS DRAWING IS A CONTROLLED DOCUMENT.

DIMENSIONS:
mmTOLERANCES UNLESS
OTHERWISE SPECIFIED:

0 PLC	±	0.3
1 PLC	±	0.2
2 PLC	±	0.15
3 PLC	±	0.1
4 PLC	±	0.05
ANGLES	±	3°

MATERIAL
SEE NOTEFINISH
SEE NOTE

DWN	—
CHK	—
APVD	—
PRODUCT SPEC	—
APPLICATION SPEC	—

WEIGHT
3.5 GRAMS

CUSTOMER DRAWING

 TE Connectivity		
NAME		
MODULAR JACK CONNECTOR RJ45, 8P8C, SHIELDED TAB UP, DIP TYPE, H=11.3mm		
SIZE	CAGE CODE	DRAWING NO
A3	00779	C=1734795
		RESTRICTED TO
SCALE		SHEET 2 OF 5
REV		E

THIS DRAWING IS UNPUBLISHED.

RELEASED FOR PUBLICATION

-,-

© COPYRIGHT 2010 BY TYCO ELECTRONICS CORPORATION. ALL RIGHTS RESERVED.


LOC
DW

DIST



REVISIONS

P	LTR	DESCRIPTION	DATE	DWN	APVD
		SEE SHEET 1.			

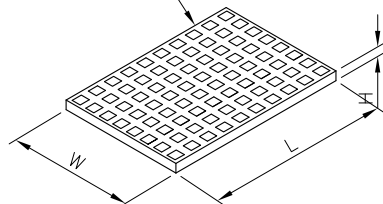TRAY
325mm(L)X216mm(W)X17.5mm(H)




INNER CARTON
345mm(L)X240mm(W)X175mm(H)

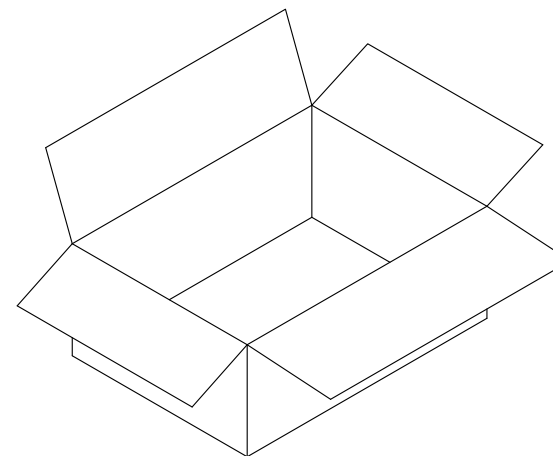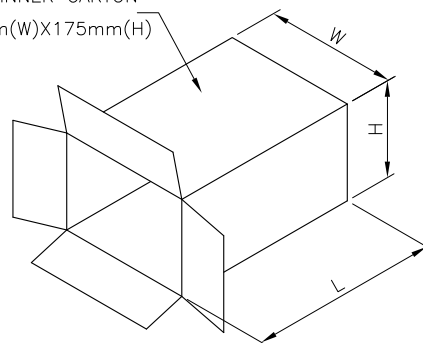



CARTON
500mm(L)X365mm(W)X195mm(H)

PACKAGE BEIT

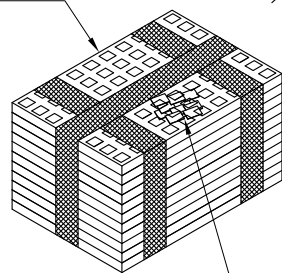TRAY (10 LAYERS)



20 DESICCATING AGENTS
AT LEAST

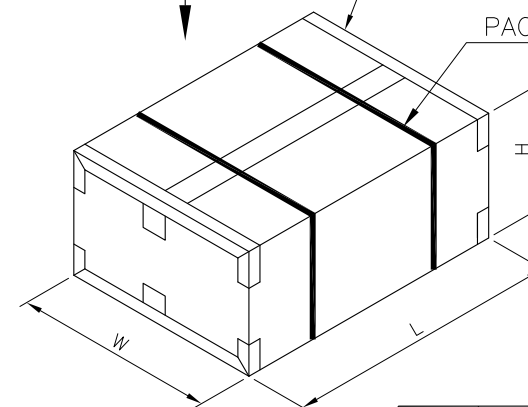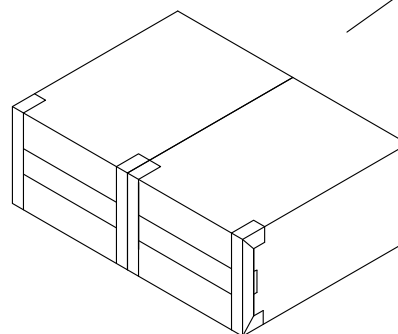


80	800	1600	8.5	6.5	1734795-4
					~~1734795-3~~
					~~1734795-2~~
					1734795-1
PCS/ TRAY	TRAYS/ CARTON	QUANTITY (PCS)	G/W (Kg)	N/W (Kg)	PART NUMBER

THIS DRAWING IS A CONTROLLED DOCUMENT.

DIMENSIONS:

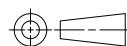mm

TOLERANCES UNLESS
OTHERWISE SPECIFIED:

0 PLC ± -
1 PLC ± 0.3
2 PLC ± 0.2
3 PLC ± 0.15
4 PLC ± -
ANGLES ± 3'

MATERIAL

FINISH

DWN

CHK

APVD

PRODUCT SPEC

APPLICATION SPEC

WEIGHT

CUSTOMER DRAWING

NAME

SIZE

CAGE CODE

DRAWING NO

RESTRICTED TO

TE Connectivity

MODULAR JACK CONNECTOR
RJ45, 8P8C, SHIELDED
TAB UP, DIP TYPE, H=11.3mm

A300779

C=1734795

SCALE

SHEET 3 of 5

REV E

D

D

C

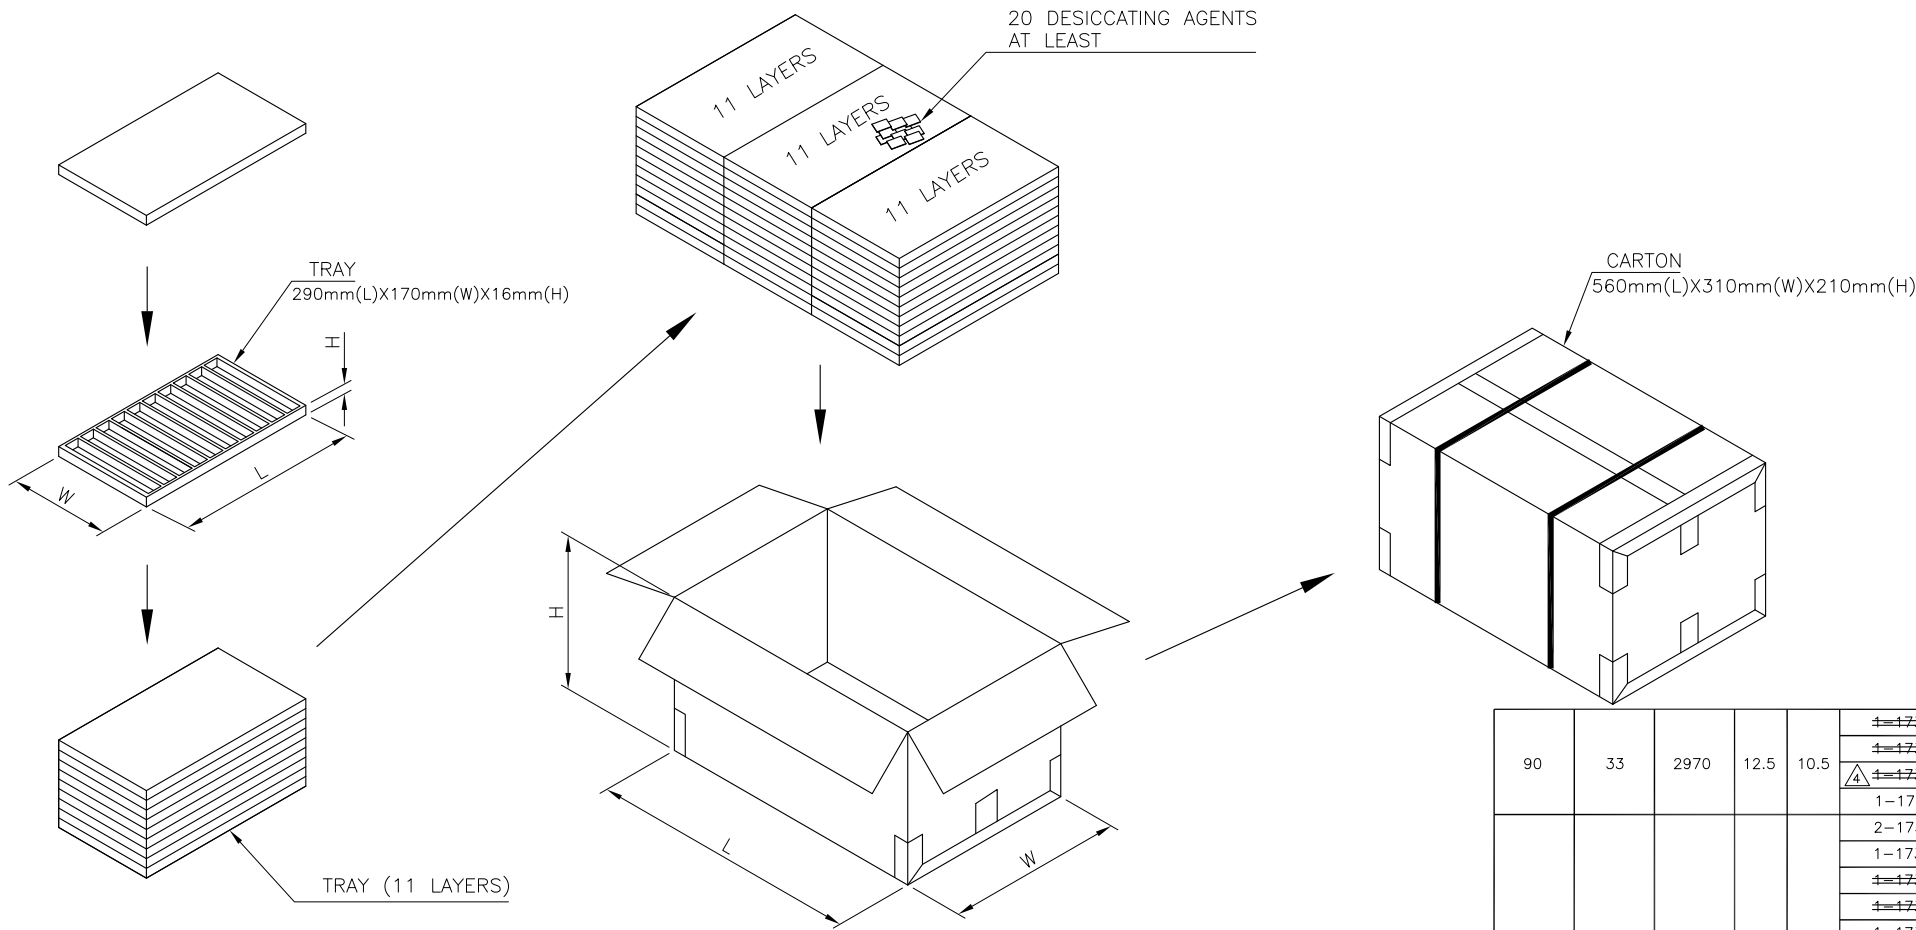
C

B

B

A

A



90	33	2970	12.5	10.5	~~1-1734795-4~~
					~~1-1734795-3~~
					~~1-1734795-2~~
					1-1734795-1
80	33	2640	11	9	2-1734795-2
					1-1734795-8
					~~1-1734795-7~~
					~~1-1734795-6~~
					1-1734795-5
					~~1734795-8~~
					1734795-7
					1734795-6
					1734795-5
PCS/TRAY	TRAYS/CARTON	QUANTITY (PCS)	G/W (Kg)	N/W (Kg)	PART NUMBER

THIS DRAWING IS A CONTROLLED DOCUMENT.

DIMENSIONS:
mm

MATERIAL

TOLERANCES UNLESS OTHERWISE SPECIFIED:

0 PLC ± -

1 PLC ± 0.3

2 PLC ± 0.2

3 PLC ± 0.15

4 PLC ± -

ANGLES ± 3°

FINISH

DWN

CHK

APVD

PRODUCT SPEC

APPLICATION SPEC

WEIGHT

CUSTOMER DRAWING

TE Connectivity

NAME

MODULAR JACK CONNECTOR
RJ45, 8P8C, SHIELDED
TAB UP, DIP TYPE, H=11.3mm

SIZE

CAGE CODE

DRAWING NO

RESTRICTED TO

A300779

C=1734795

SCALE

SHEET

4 of 5

REV

E

Компания «Life Electronics» занимается поставками электронных компонентов импортного и отечественного производства от производителей и со складов крупных дистрибьюторов Европы, Америки и Азии.

С конца 2013 года компания активно расширяет линейку поставок компонентов по направлению коаксиальный кабель, кварцевые генераторы и конденсаторы (керамические, пленочные, электролитические), за счёт заключения дистрибьюторских договоров

Мы предлагаем:

- Конкурентоспособные цены и скидки постоянным клиентам.
- Специальные условия для постоянных клиентов.
- Подбор аналогов.
- Поставку компонентов в любых объемах, удовлетворяющих вашим потребностям.
- Приемлемые сроки поставки, возможна ускоренная поставка.
- Доставку товара в любую точку России и стран СНГ.
- Комплексную поставку.
- Работу по проектам и поставку образцов.
- Формирование склада под заказчика.
- Сертификаты соответствия на поставляемую продукцию (по желанию клиента).
- Тестирование поставляемой продукции.
- Поставку компонентов, требующих военную и космическую приемку.
- Входной контроль качества.
- Наличие сертификата ISO.

В составе нашей компании организован Конструкторский отдел, призванный помогать разработчикам, и инженерам.

Конструкторский отдел помогает осуществить:

- Регистрацию проекта у производителя компонентов.
- Техническую поддержку проекта.
- Защиту от снятия компонента с производства.
- Оценку стоимости проекта по компонентам.
- Изготовление тестовой платы монтаж и пусконаладочные работы.



Тел: +7 (812) 336 43 04 (многоканальный)

Email: org@lifeelectronics.ru

www.lifeelectronics.ru