

THIS DRAWING IS UNPUBLISHED.

RELEASED FOR PUBLICATION

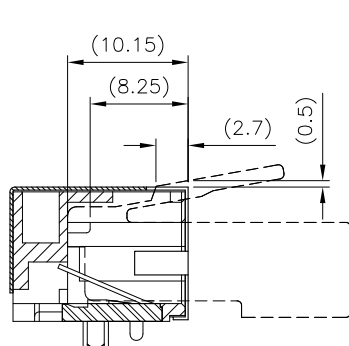
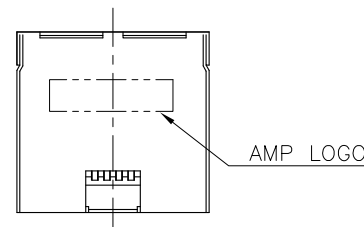
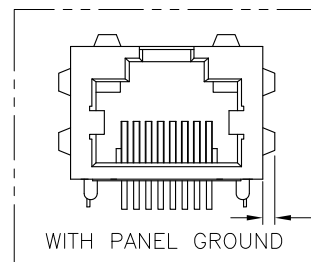
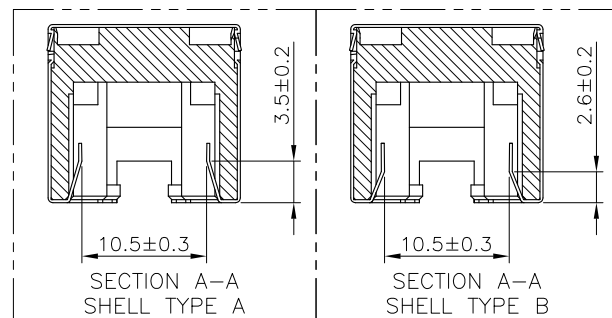
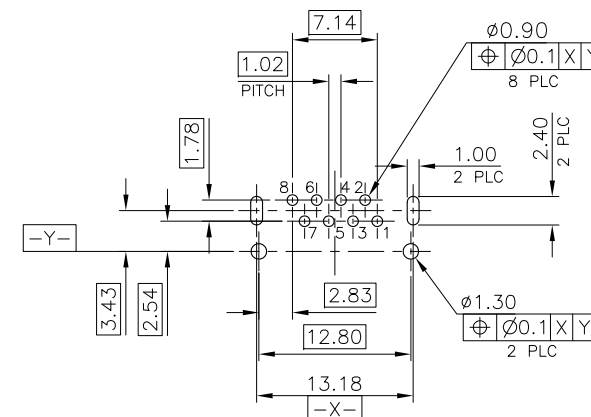
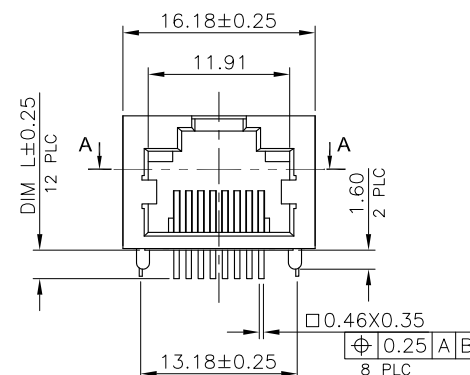
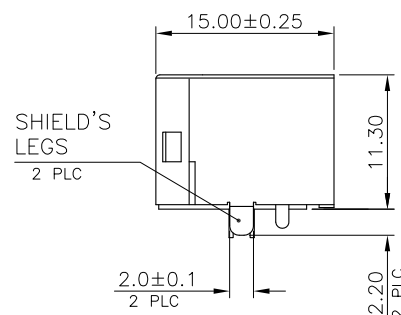
© COPYRIGHT 2010 BY TYCO ELECTRONICS CORPORATION. ALL RIGHTS RESERVED.

LOC  
DW

DIST

REVISIONS

| P | LTR | DESCRIPTION                                                          | DATE     | DWN  | APVD |
|---|-----|----------------------------------------------------------------------|----------|------|------|
| E |     | REVISED (ECR-12-012115)<br>OBSOLETE PNS: -3, -8, -13, -14, -16 & -17 | 26OCT'12 | E.L. | W.K. |

MATING WITH RJ-45 PLUG  
(REFERENCE)RECOMMENDED PCB LAYOUT (THICKNESS: 1.6MM)  
(DIMENSION TOLERANCE: 1 PLC: ±0.1, 2 PLC: ±0.05)

NOTE:

1. MATERIAL:

1.1 HOUSING: PA9T WITH 30% GF, UL94 V-0, BLACK COLOR.

1.2 CONTACTS: PHOSPHOR BRONZE.

1.3 SHELL: BRASS.

2. FINISH:

2.1 CONTACTS:

(SEE TABLE) GOLD PLATED ON CONTACT AREA.

GOLD FLASH ON SOLDER TAIL.

1.27µm [50u"] MIN. NICKEL UNDERPLATED OVERALL.

2.2 SHELL: 0.51µm [20u"] MIN. NICKEL PLATED.

3. WAVE SOLDER CAPABLE TO 265°C PER TYCO TEST SPEC. 109-202, CONDITION B.

⚠ OBSOLETE PART : OBSOLETE CIS STREAMLINING PER D.RENAUD/D.SINISI

THIS DRAWING IS A CONTROLLED DOCUMENT.

|                      |                                           |
|----------------------|-------------------------------------------|
| DIMENSIONS:<br>mm    | TOLERANCES UNLESS<br>OTHERWISE SPECIFIED: |
| 0 PLC                | ± .                                       |
| 1 PLC                | ± 0.3                                     |
| 2 PLC                | ± 0.2                                     |
| 3 PLC                | ± 0.15                                    |
| 4 PLC                | ± .                                       |
| ANGLES               | ± 3°                                      |
| MATERIAL<br>SEE NOTE | FINISH<br>SEE NOTE                        |

|                  |           |
|------------------|-----------|
| DWN<br>O. HU     | 14SEP2007 |
| CHK<br>S. HOU    | 14SEP2007 |
| APVD<br>W.J. KE  | 14SEP2007 |
| PRODUCT SPEC     | 108-57535 |
| APPLICATION SPEC |           |
| WEIGHT           | 3.5 GRAMS |
| CUSTOMER DRAWING |           |

|    |                 |                           |     |               |                      |                        |                      |
|----|-----------------|---------------------------|-----|---------------|----------------------|------------------------|----------------------|
|    | TAPE<br>& REEL  | W/O                       | W/O | TYPE A        | 2.2                  | 6u"                    | 3-1734795-2          |
|    |                 |                           |     |               | 1.5                  | 6u"                    | 3-1734795-1          |
| TE | TRAY            | W/<br><br><br><br><br>W/O |     |               | 2.4                  | 50u"                   | <del>1734795-8</del> |
|    |                 |                           |     |               |                      | 30u"                   | 1734795-7            |
|    |                 |                           |     |               |                      | 15u"                   | 1734795-6            |
|    |                 |                           |     | 6u"           |                      | 1734795-5              |                      |
|    |                 |                           |     | 50u"          |                      | 1734795-4              |                      |
| TE | W/O             | TYPE B                    |     | 30u"          | <del>1734795-3</del> |                        |                      |
| TE |                 | TYPE A                    |     | 15u"          | <del>1734795-2</del> |                        |                      |
|    |                 |                           |     | 6u"           | 1734795-1            |                        |                      |
|    | PACKAGE<br>TYPE | PANEL<br>GROUND           | LED | SHELL<br>TYPE | DIM L                | MIN. GOLD<br>THICKNESS | PART NUMBER          |

STE

TE Connectivity

|       |  |           |  |            |                                                                              |        |               |     |  |
|-------|--|-----------|--|------------|------------------------------------------------------------------------------|--------|---------------|-----|--|
| NAME  |  |           |  |            | MODULAR JACK CONNECTOR<br>RJ45, 8P8C, SHIELDED<br>TAB UP, DIP TYPE, H=11.3mm |        |               |     |  |
| SIZE  |  | CAGE CODE |  | DRAWING NO |                                                                              |        | RESTRICTED TO |     |  |
| A3    |  | 00779     |  | C=1734795  |                                                                              |        | —             |     |  |
| SCALE |  |           |  | SHEET      |                                                                              | 1 OF 5 |               | REV |  |
|       |  |           |  |            |                                                                              |        |               | E   |  |



THIS DRAWING IS UNPUBLISHED.

RELEASED FOR PUBLICATION

-,-



COPYRIGHT 2010

BY TYCO ELECTRONICS CORPORATION.

ALL RIGHTS RESERVED.

LOC  
DW

DIST

REVISIONS

P

LTR

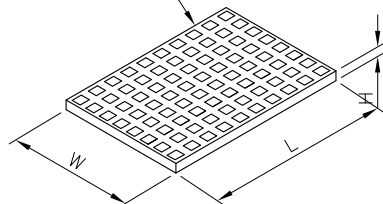
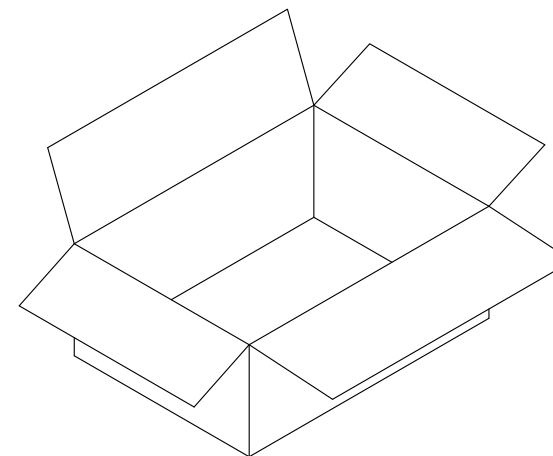
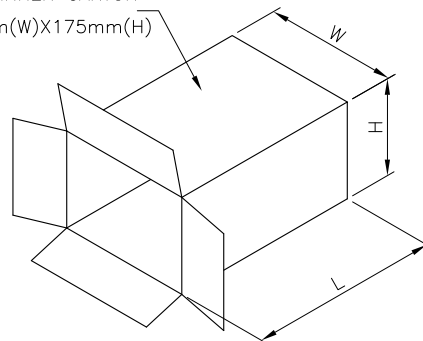
DESCRIPTION

DATE

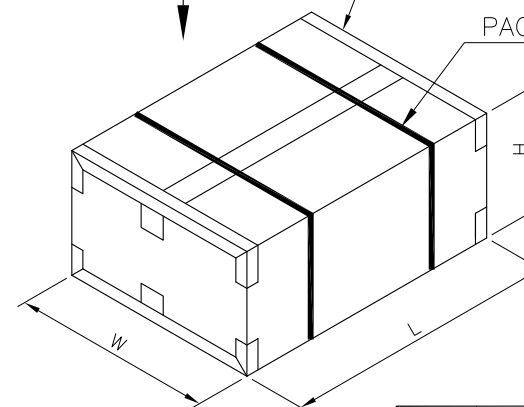
DWN

APVD

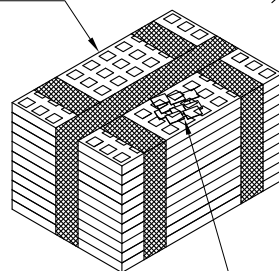
SEE SHEET 1.

TRAY  
325mm(L)X216mm(W)X17.5mm(H)INNER CARTON  
345mm(L)X240mm(W)X175mm(H)CARTON  
500mm(L)X365mm(W)X195mm(H)

PACKAGE BEIT



TRAY (10 LAYERS)

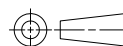
20 DESICCATING AGENTS  
AT LEAST

|              |                  |                   |             |             |                      |
|--------------|------------------|-------------------|-------------|-------------|----------------------|
| 80           | 800              | 1600              | 8.5         | 6.5         | 1734795-4            |
|              |                  |                   |             |             | <del>1734795-3</del> |
|              |                  |                   |             |             | <del>1734795-2</del> |
|              |                  |                   |             |             | 1734795-1            |
| PCS/<br>TRAY | TRAYS/<br>CARTON | QUANTITY<br>(PCS) | G/W<br>(Kg) | N/W<br>(Kg) | PART NUMBER          |

THIS DRAWING IS A CONTROLLED DOCUMENT.

DIMENSIONS:

mm



MATERIAL

TOLERANCES UNLESS  
OTHERWISE SPECIFIED:

|        |        |
|--------|--------|
| 0 PLC  | ± .    |
| 1 PLC  | ± 0.3  |
| 2 PLC  | ± 0.2  |
| 3 PLC  | ± 0.15 |
| 4 PLC  | ± .    |
| ANGLES | ± 3°   |

FINISH

|                  |   |
|------------------|---|
| DWN              | — |
| CHK              | — |
| APVD             | — |
| PRODUCT SPEC     | — |
| APPLICATION SPEC | — |
| WEIGHT           | — |
| CUSTOMER DRAWING | — |



TE Connectivity

NAME

MODULAR JACK CONNECTOR  
RJ45, 8P8C, SHIELDED  
TAB UP, DIP TYPE, H=11.3mm

SIZE

CAGE CODE

DRAWING NO

RESTRICTED TO

A3

00779

C=1734795

SCALE

SHEET

3 of 5

REV E

D

D

C

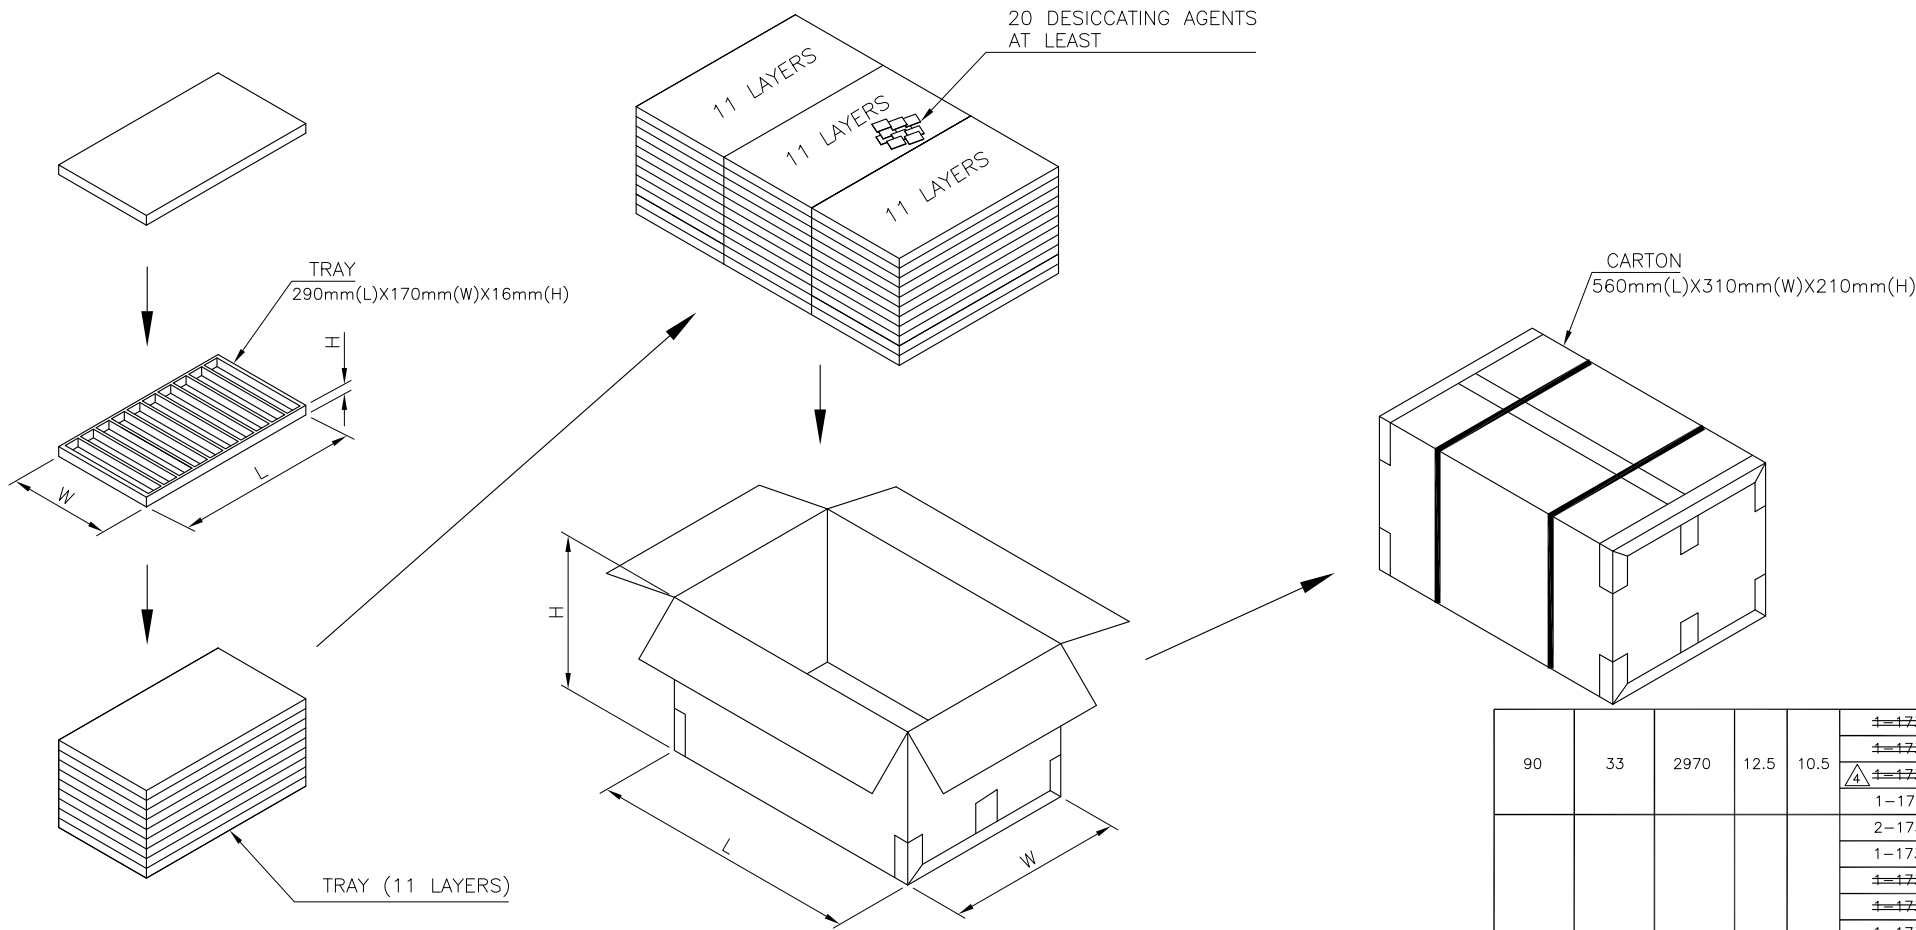
C

B

B

A

A



|          |              |                |          |          |                        |
|----------|--------------|----------------|----------|----------|------------------------|
| 90       | 33           | 2970           | 12.5     | 10.5     | <del>1-1734795-4</del> |
|          |              |                |          |          | <del>1-1734795-3</del> |
|          |              |                |          |          | <del>1-1734795-2</del> |
|          |              |                |          |          | 1-1734795-1            |
| 80       | 33           | 2640           | 11       | 9        | 2-1734795-2            |
|          |              |                |          |          | 1-1734795-8            |
|          |              |                |          |          | <del>1-1734795-7</del> |
|          |              |                |          |          | <del>1-1734795-6</del> |
|          |              |                |          |          | 1-1734795-5            |
|          |              |                |          |          | <del>1734795-8</del>   |
|          |              |                |          |          | 1734795-7              |
| PCS/TRAY | TRAYS/CARTON | QUANTITY (PCS) | G/W (Kg) | N/W (Kg) | 1734795-6              |
|          |              |                |          |          | 1734795-5              |
|          |              |                |          |          | PART NUMBER            |

THIS DRAWING IS A CONTROLLED DOCUMENT.

DIMENSIONS: mm

MATERIAL

TOLERANCES UNLESS OTHERWISE SPECIFIED:

0 PLC ± .

1 PLC ± 0.3

2 PLC ± 0.2

3 PLC ± 0.15

4 PLC ± .

ANGLES ± 3°

FINISH

DWN

CHK

APVD

PRODUCT SPEC

APPLICATION SPEC

WEIGHT

CUSTOMER DRAWING

TE Connectivity

NAME

MODULAR JACK CONNECTOR  
RJ45, 8P8C, SHIELDED  
TAB UP, DIP TYPE, H=11.3mm

SIZE

CAGE CODE

DRAWING NO

RESTRICTED TO

A3

00779

C=1734795

SCALE

SHEET 4 of 5

REV E



Компания «Life Electronics» занимается поставками электронных компонентов импортного и отечественного производства от производителей и со складов крупных дистрибьюторов Европы, Америки и Азии.

С конца 2013 года компания активно расширяет линейку поставок компонентов по направлению коаксиальный кабель, кварцевые генераторы и конденсаторы (керамические, пленочные, электролитические), за счёт заключения дистрибьюторских договоров

Мы предлагаем:

- Конкурентоспособные цены и скидки постоянным клиентам.
- Специальные условия для постоянных клиентов.
- Подбор аналогов.
- Поставку компонентов в любых объемах, удовлетворяющих вашим потребностям.
- Приемлемые сроки поставки, возможна ускоренная поставка.
- Доставку товара в любую точку России и стран СНГ.
- Комплексную поставку.
- Работу по проектам и поставку образцов.
- Формирование склада под заказчика.
- Сертификаты соответствия на поставляемую продукцию (по желанию клиента).
- Тестирование поставляемой продукции.
- Поставку компонентов, требующих военную и космическую приемку.
- Входной контроль качества.
- Наличие сертификата ISO.

В составе нашей компании организован Конструкторский отдел, призванный помогать разработчикам, и инженерам.

Конструкторский отдел помогает осуществить:

- Регистрацию проекта у производителя компонентов.
- Техническую поддержку проекта.
- Защиту от снятия компонента с производства.
- Оценку стоимости проекта по компонентам.
- Изготовление тестовой платы монтаж и пусконаладочные работы.



Тел: +7 (812) 336 43 04 (многоканальный)

Email: [org@lifeelectronics.ru](mailto:org@lifeelectronics.ru)

[www.lifeelectronics.ru](http://www.lifeelectronics.ru)