

THIS DRAWING IS UNPUBLISHED.

RELEASED FOR PUBLICATION

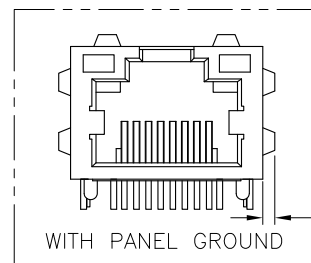
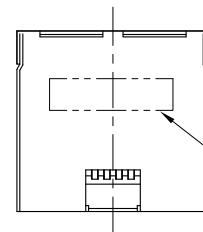
© COPYRIGHT 2010 BY TYCO ELECTRONICS CORPORATION. ALL RIGHTS RESERVED.

LOC
DW

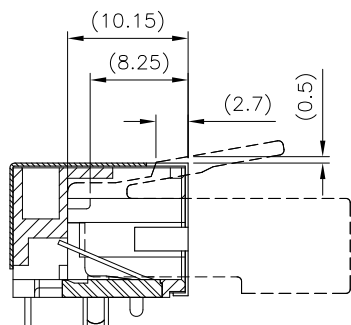
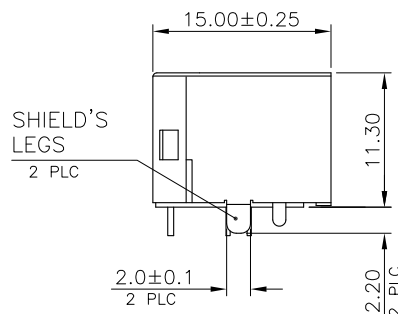
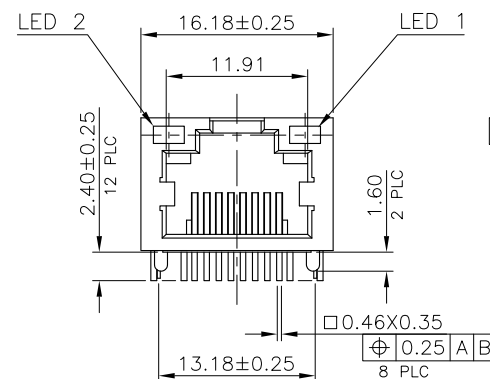
DIST

REVISIONS

P	LTR	DESCRIPTION	DATE	DWN	APVD
		SEE SHEET 1.			

0.8~2.0
6 PLC

AMP LOGO

MATING WITH RJ-45 PLUG
(REFERENCE)SHIELD'S
LEGS
2 PLC

LED 2

LED 1

0.46X0.35
8 PLC

0.25 A B

8 PLC

8 PLC

THIS DRAWING IS UNPUBLISHED.

RELEASED FOR PUBLICATION

-,-



COPYRIGHT 2010

BY TYCO ELECTRONICS CORPORATION.

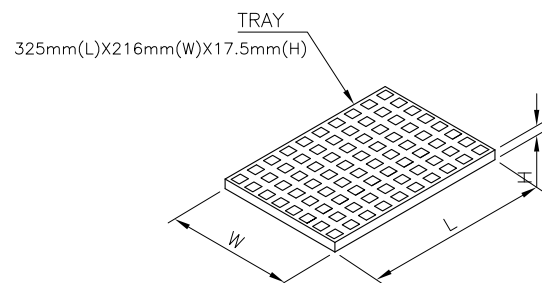
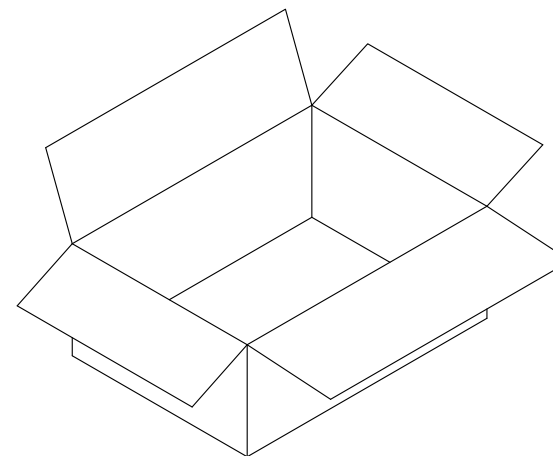
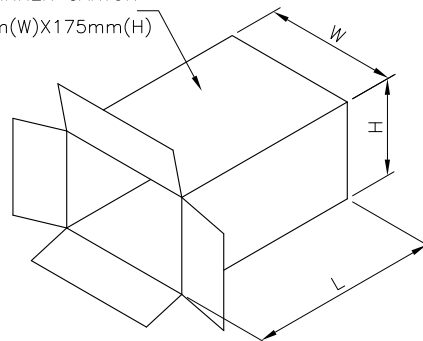
ALL RIGHTS RESERVED.

LOC
DW

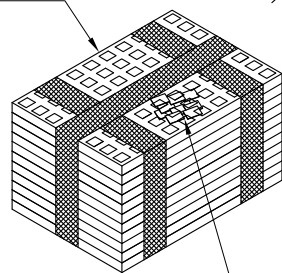
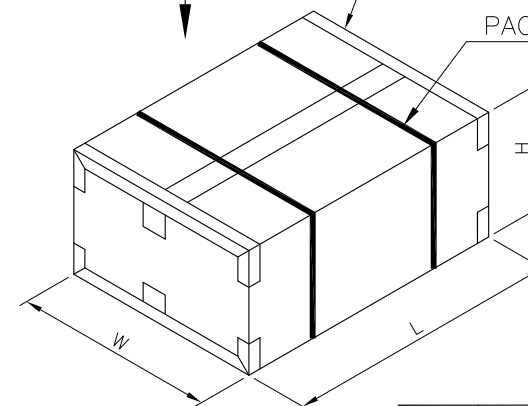
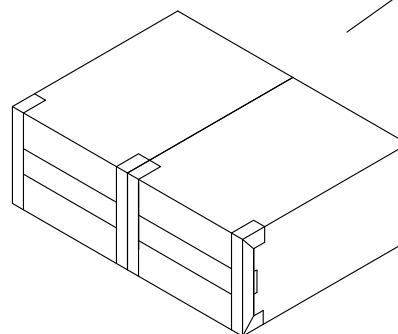
DIST

REVISIONS

P	LTR	DESCRIPTION	DATE	DWN	APVD
		SEE SHEET 1.			

INNER CARTON
345mm(L)X240mm(W)X175mm(H)CARTON
500mm(L)X365mm(W)X195mm(H)

TRAY (10 LAYERS)

20 DESICCATING AGENTS
AT LEAST

PACKAGE BEIT

80	800	1600	8.5	6.5	1734795-4
					~~1734795-3~~
					~~1734795-2~~
					1734795-1
PCS/ TRAY	TRAYS/ CARTON	QUANTITY (PCS)	G/W (Kg)	N/W (Kg)	PART NUMBER

THIS DRAWING IS A CONTROLLED DOCUMENT.

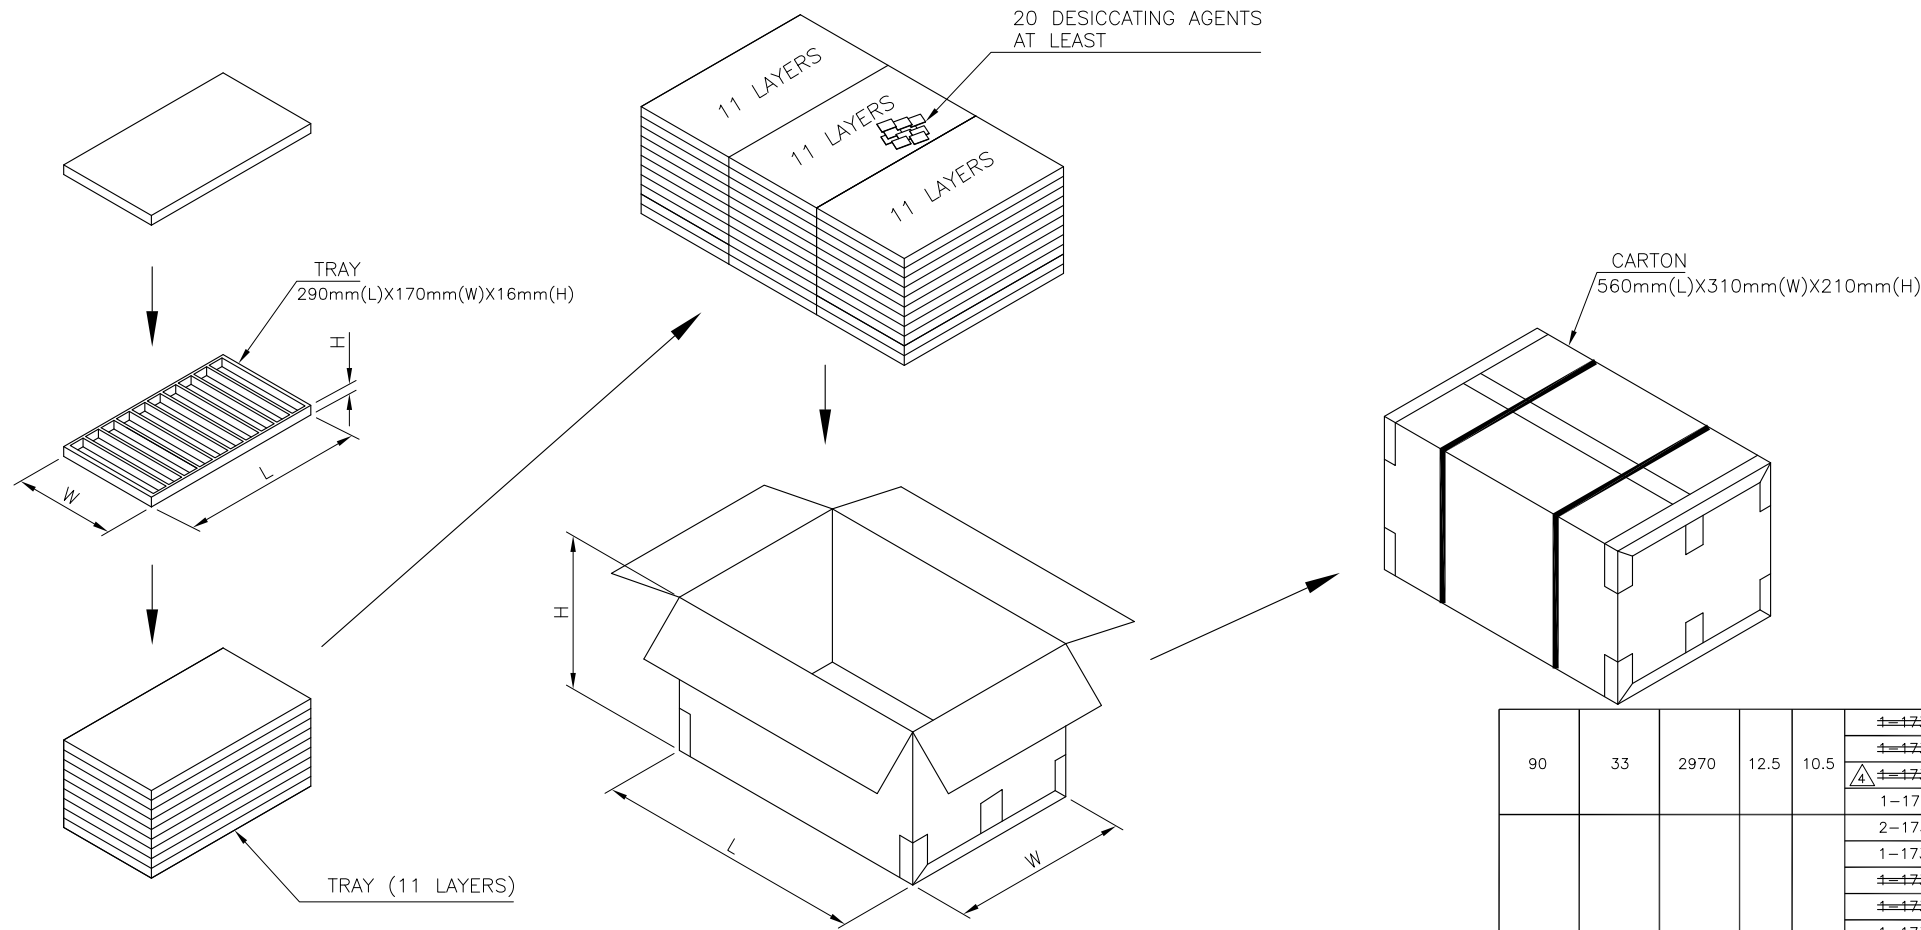
DIMENSIONS:	TOLERANCES UNLESS OTHERWISE SPECIFIED:
mm	
	0 PLC ± .
	1 PLC ± 0.3
	2 PLC ± 0.2
	3 PLC ± 0.15
	4 PLC ± .
	ANGLES ± 3'
MATERIAL	FINISH

DWN	—
CHK	—
APVD	—
PRODUCT SPEC	—
APPLICATION SPEC	—
WEIGHT	—
CUSTOMER DRAWING	—



TE Connectivity

NAME	MODULAR JACK CONNECTOR RJ45, 8P8C, SHIELDED TAB UP, DIP TYPE, H=11.3mm
SIZE	A3
CAGE CODE	00779
DRAWING NO	C=1734795
RESTRICTED TO	—
SCALE	—
SHEET	3 of 5
REV	E



90	33	2970	12.5	10.5	~~1-1734795-4~~
					~~1-1734795-3~~
					~~1-1734795-2~~
					1-1734795-1
					2-1734795-2
					1-1734795-8
					~~1-1734795-7~~
					~~1-1734795-6~~
					1-1734795-5
					~~1734795-8~~
					1734795-7
					1734795-6
					1734795-5
PCS/ TRAY	TRAYS/ CARTON	QUANTITY (PCS)	G/W (Kg)	N/W (Kg)	PART NUMBER

THIS DRAWING IS A CONTROLLED DOCUMENT.

DIMENSIONS:
mm

MATERIAL

TOLERANCES UNLESS OTHERWISE SPECIFIED:

0 PLC ± -

1 PLC ± 0.3

2 PLC ± 0.2

3 PLC ± 0.15

4 PLC ± -

ANGLES ± 3°

FINISH

DWN

CHK

APVD

PRODUCT SPEC

APPLICATION SPEC

WEIGHT

TE Connectivity

NAME

MODULAR JACK CONNECTOR
RJ45, 8P8C, SHIELDED
TAB UP, DIP TYPE, H=11.3mm

SIZE

CAGE CODE

DRAWING NO

RESTRICTED TO

CUSTOMER DRAWING

SCALE

SHEET 4 of 5

REV E

A3

00779

C=1734795

THIS DRAWING IS UNPUBLISHED.

RELEASED FOR PUBLICATION

ALL RIGHTS RESERVED.

© COPYRIGHT 2010 BY TYCO ELECTRONICS CORPORATION.

LOC
DW

DIST

REVISIONS

P

LTR

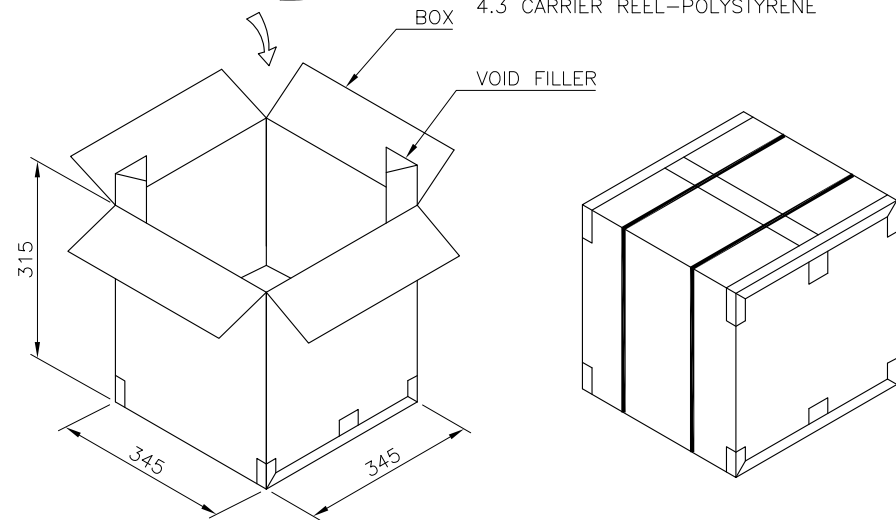
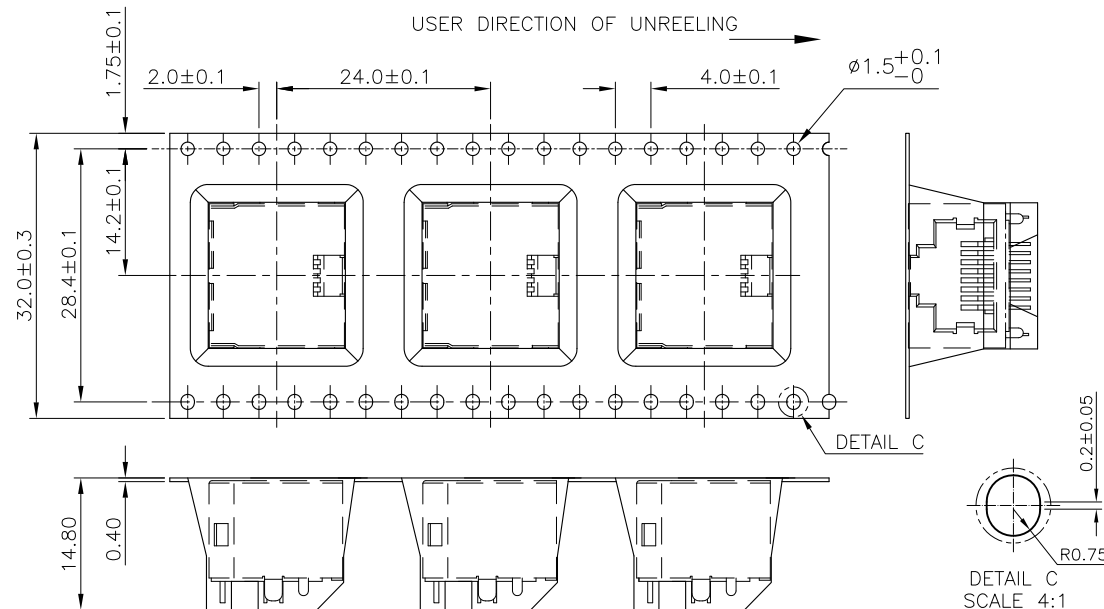
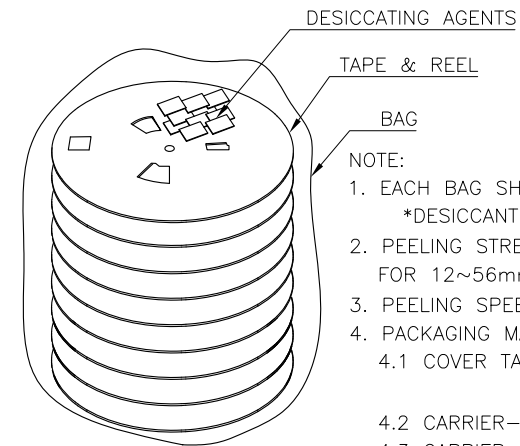
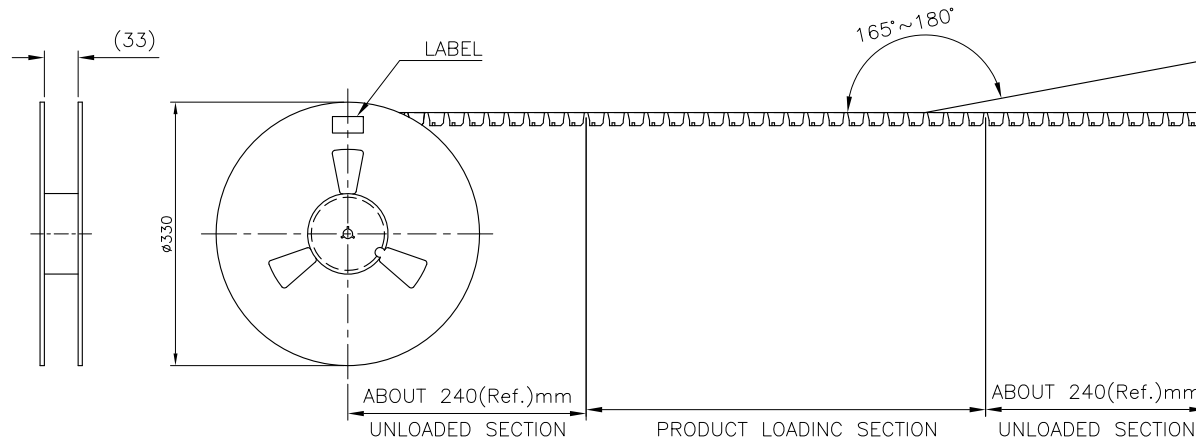
DESCRIPTION

DATE

DWN

APVD

SEE SHEET 1.



8.7 KG	5.05 KG	180	8	1440	3-1734795-2
GROSS WEIGHT	NET WEIGHT	PCS/ REEL	REEL/ BOX	PCS/ BOX	PART NUMBER
					3-1734795-1

THIS DRAWING IS A CONTROLLED DOCUMENT.

DIMENSIONS:

mm

TOLERANCES UNLESS OTHERWISE SPECIFIED:

0 PLC ± .

1 PLC ± 0.3

2 PLC ± 0.2

3 PLC ± 0.15

4 PLC ± .

ANGLES ± 3°

MATERIAL

FINISH

DWN

CHK

APVD

PRODUCT SPEC

APPLICATION SPEC

WEIGHT

CUSTOMER DRAWING

STE

TE Connectivity

NAME

MODULAR JACK CONNECTOR

RJ45, 8P8C, SHIELDED

TAB UP, DIP TYPE, H=11.3mm

SIZE

CAGE CODE

DRAWING NO

RESTRICTED TO

A3

00779

C=1734795

SCALE

SHEET

5 of 5

REV

E

Компания «Life Electronics» занимается поставками электронных компонентов импортного и отечественного производства от производителей и со складов крупных дистрибьюторов Европы, Америки и Азии.

С конца 2013 года компания активно расширяет линейку поставок компонентов по направлению коаксиальный кабель, кварцевые генераторы и конденсаторы (керамические, пленочные, электролитические), за счёт заключения дистрибьюторских договоров

Мы предлагаем:

- Конкурентоспособные цены и скидки постоянным клиентам.
- Специальные условия для постоянных клиентов.
- Подбор аналогов.
- Поставку компонентов в любых объемах, удовлетворяющих вашим потребностям.
- Приемлемые сроки поставки, возможна ускоренная поставка.
- Доставку товара в любую точку России и стран СНГ.
- Комплексную поставку.
- Работу по проектам и поставку образцов.
- Формирование склада под заказчика.
- Сертификаты соответствия на поставляемую продукцию (по желанию клиента).
- Тестирование поставляемой продукции.
- Поставку компонентов, требующих военную и космическую приемку.
- Входной контроль качества.
- Наличие сертификата ISO.

В составе нашей компании организован Конструкторский отдел, призванный помогать разработчикам, и инженерам.

Конструкторский отдел помогает осуществить:

- Регистрацию проекта у производителя компонентов.
- Техническую поддержку проекта.
- Защиту от снятия компонента с производства.
- Оценку стоимости проекта по компонентам.
- Изготовление тестовой платы монтаж и пусконаладочные работы.



Тел: +7 (812) 336 43 04 (многоканальный)

Email: org@lifeelectronics.ru

www.lifeelectronics.ru