THIS DRAWING IS UNPUBLISHED. RELEASED FOR PUBLICATION -,- .
© COPYRIGHT - By - ALL RIGHTS RESERVED.

LOC	DIST
AD	00

REVISIONS

P	LTR	DESCRIPTION	DATE	DWN	APVD
	Z2	REVISED PER ECO-11-004587	11MAR11	RK	HMR

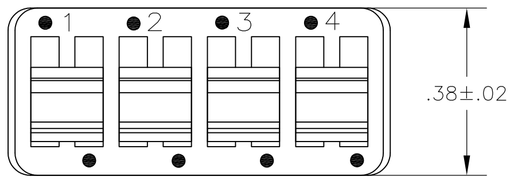

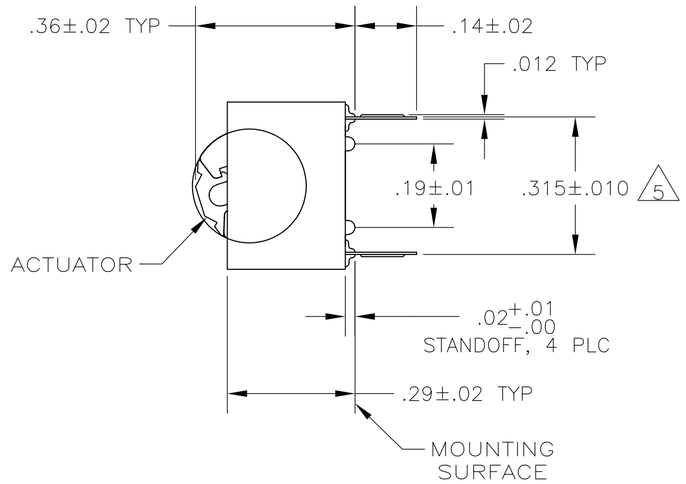

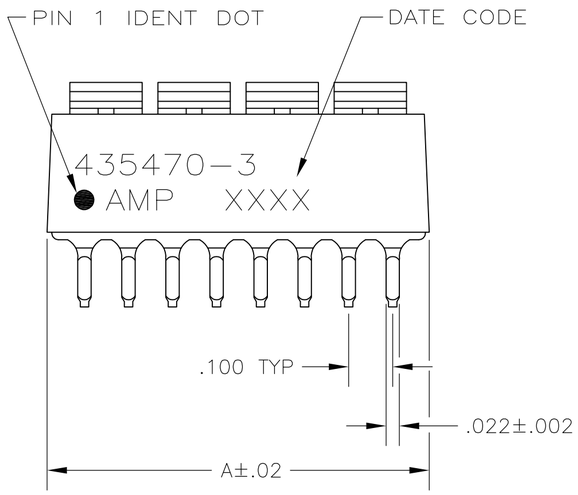

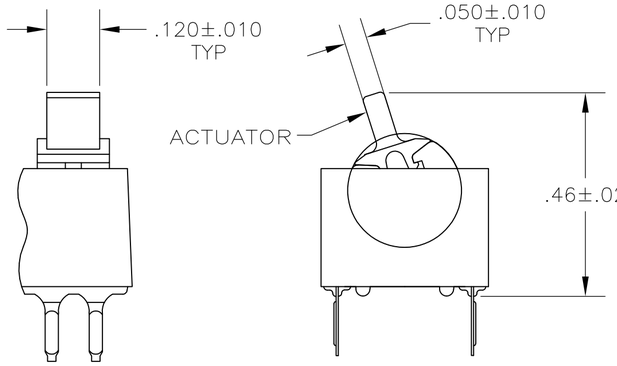

FIGURE 1
LEVER ACTUATOR SHOWN

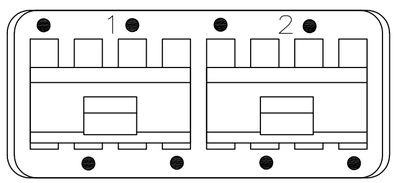

FIGURE 2

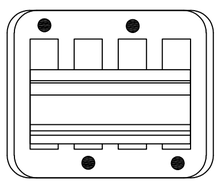

FIGURE 3

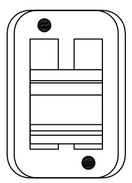

FIGURE 4

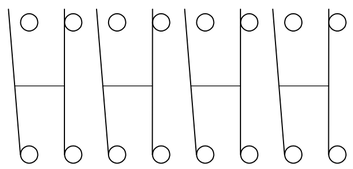

SPDT

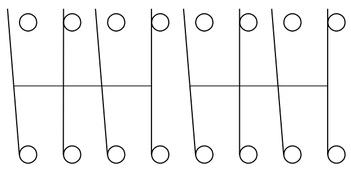

DPDT

CONTACT ARRANGEMENT

1. FOR ADDITIONAL SPECIFICATIONS SEE AMP PRODUCT SPEC 108-7519.
2. SWITCH HAS MAKE-BEFORE-BREAK OPERATION.
3. ALL CHARACTERS AND ROCKERS ARE WHITE, HOUSING IS BLACK.
4. STAMPING WILL VARY ON 2 POSITION SIDES DUE TO SPACE RESTRICTIONS.

△5 .315 DIMENSION APPLIES AT TERMINAL TIPS. TERMINALS ARE .300 +.010 −.000 AT MOUNTING SURFACE.

6 SWITCH POSITIONS ARE CLOSED WHEN ROCKERS ARE DOWN TOWARD DOTS.

△7 ALL MATERIALS AND FINISHES SHALL COMPLY WITH EU DIRECTIVE 2002/95/EC OF 27JAN2003 (ROHS).

△8 OBSOLETE PARTS: OBSOLETE CIS STREAMLINING PER D.RENAUD/D.SINISI

ACTUATOR	TOP MARKING	A	SWITCH TYPE	NO OF POSN	PART NO
	FIG 1	FIG 3	.48	DPDT	4	8-435470-1 △7
OBSOLETE △8	~~FIG 1~~	~~AS SHOWN~~	~~1.28~~	~~SPDT~~	~~12~~	~~7-435470-6~~ △7
	~~FIG 1~~	~~AS SHOWN~~	~~1.08~~	~~SPDT~~	~~10~~	~~7-435470-5~~ △7
	~~FIG 1~~	~~AS SHOWN~~	~~.88~~	~~SPDT~~	~~8~~	~~7-435470-4~~ △7
	~~FIG 1~~	~~AS SHOWN~~	~~.48~~	~~SPDT~~	~~4~~	~~7-435470-2~~ △7
	FIG 1	FIG 4	.28	SPDT	2	7-435470-1 △7
△8 OBSOLETE	~~AS SHOWN~~	~~FIG 2~~	~~.88~~	~~DPDT~~	~~8~~	~~5-435470-9~~ △7
	AS SHOWN	FIG 4	.28	SPDT	2	5-435470-7 △7
	AS SHOWN	FIG 3	.48	DPDT	4	5-435470-5 △7
	AS SHOWN	AS SHOWN	.88	SPDT	8	5-435470-3 △7
	AS SHOWN	AS SHOWN	.68	SPDT	6	5-435470-2 △7
△8 OBSOLETE	~~AS SHOWN~~	~~AS SHOWN~~	~~.48~~	~~SPDT~~	~~4~~	~~5-435470-1~~ △7
OBSOLETE	FIG 1	FIG 2	1.28	DPDT	12	3-435470-3
SUPERSEDED BY 435470-9	FIG 1	FIG 2	.88	DPDT	8	3-435470-2
	FIG 1	FIG 3	.48	DPDT	4	3-435470-1
OBSOLETE	FIG 1	NONE	.88	SPDT	8	2-435470-7
OBSOLETE △8	~~FIG 1~~	~~AS SHOWN~~	~~1.28~~	~~SPDT~~	~~12~~	~~2-435470-6~~
	~~FIG 1~~	~~AS SHOWN~~	~~1.08~~	~~SPDT~~	~~10~~	~~2-435470-5~~
	FIG 1	AS SHOWN	.88	SPDT	8	2-435470-4
OBSOLETE	FIG 1	AS SHOWN	.68	SPDT	6	2-435470-3
OBSOLETE △8	~~FIG 1~~	~~AS SHOWN~~	~~.48~~	~~SPDT~~	~~4~~	~~2-435470-2~~
	~~FIG 1~~	~~FIG 4~~	~~.28~~	~~SPDT~~	~~2~~	~~2-435470-1~~
	AS SHOWN	FIG 2	.88	DPDT	8	435470-9
SUPERSEDED BY 2-435470-6	AS SHOWN	AS SHOWN	1.28	SPDT	12	435470-8
	AS SHOWN	FIG 4	.28	SPDT	2	435470-7
	AS SHOWN	FIG 3	.48	DPDT	4	435470-5
SUPERSEDED BY 2-435470-5	AS SHOWN	AS SHOWN	1.08	SPDT	10	435470-4
	AS SHOWN	AS SHOWN	.88	SPDT	8	435470-3
	AS SHOWN	AS SHOWN	.68	SPDT	6	435470-2
435470-3 SHOWN △8 OBSOLETE	~~AS SHOWN~~	~~AS SHOWN~~	~~.48~~	~~SPDT~~	~~4~~	~~435470-1~~

435470

THIS DRAWING IS A CONTROLLED DOCUMENT.

DIMENSIONS: INCHES

TOLERANCES UNLESS OTHERWISE SPECIFIED:
0 PLC ± -
1 PLC ± -
2 PLC ± -
3 PLC ± .005
4 PLC ± -
ANGLES ± -

MATERIAL
HOUSING & ROCKER; POLYESTER
CONTACTS; BERYLLIUM COPPER

FINISH
CONTACTS; PLATED .000030 MIN GOLD IN CONTACT AREA OVER .000050 MIN NICKEL.

DWN	R.TALLEY	15MAR90
CHK	R.MILLER	27MAR90
APVD	H.LEITER	27MAR90
PRODUCT SPEC	—	
APPLICATION SPEC	—	
WEIGHT	—	

TE Connectivity

NAME
SWITCH ASSY, DIP, TYPE C, 7000 SERIES, SPDT & DPDT

SIZE	CAGE CODE	DRAWING NO	RESTRICTED TO
A2	00779	C-435470	—

CUSTOMER DRAWING | SCALE 4:1 | SHEET 1 OF 1 | REV Z2

LifeElectronics
Живое партнерство

ООО «ЛайфЭлектроникс» **“LifeElectronics” LLC**

ИНН 7805602321 КПП 780501001 Р/С 40702810122510004610 ФАКБ "АБСОЛЮТ БАНК" (ЗАО) в г.Санкт-Петербурге К/С 30101810900000000703 БИК 044030703

Компания «Life Electronics» занимается поставками электронных компонентов импортного и отечественного производства от производителей и со складов крупных дистрибьюторов Европы, Америки и Азии.

С конца 2013 года компания активно расширяет линейку поставок компонентов по направлению коаксиальный кабель, кварцевые генераторы и конденсаторы (керамические, пленочные, электролитические), за счёт заключения дистрибьюторских договоров

Мы предлагаем:

- *Конкурентоспособные цены и скидки постоянным клиентам.*
- *Специальные условия для постоянных клиентов.*
- *Подбор аналогов.*
- *Поставку компонентов в любых объемах, удовлетворяющих вашим потребностям.*

- *Приемлемые сроки поставки, возможна ускоренная поставка.*
- *Доставку товара в любую точку России и стран СНГ.*
- *Комплексную поставку.*
- *Работу по проектам и поставку образцов.*
- *Формирование склада под заказчика.*

- *Сертификаты соответствия на поставляемую продукцию (по желанию клиента).*
- *Тестирование поставляемой продукции.*
- *Поставку компонентов, требующих военную и космическую приемку.*
- *Входной контроль качества.*
- *Наличие сертификата ISO.*

В составе нашей компании организован Конструкторский отдел, призванный помогать разработчикам, и инженерам.

Конструкторский отдел помогает осуществить:

- *Регистрацию проекта у производителя компонентов.*
- *Техническую поддержку проекта.*
- *Защиту от снятия компонента с производства.*
- *Оценку стоимости проекта по компонентам.*
- *Изготовление тестовой платы монтаж и пусконаладочные работы.*

Тел: +7 (812) 336 43 04 (многоканальный)
Email: org@lifeelectronics.ru

www.lifeelectronics.ru