NOTES:

1.0 MATERIALS:

1.1 HOUSING: STAINLESS STEEL PER ASTM-A582, TYPE 303.

1.2 CENTER CONTACT: BERYLLIUM COPPER ROD ALLOY C172, PER ASTM-B196.

1.3 DIELECTRIC: PTFE FLUOROCARBON PER ASTM-D1457.

2.0 PLATING:

2.1 HOUSING, ~~CHAIN~~ & NUT: GOLD PLATE PER MIL-G-45204 TYPE II, CLASS 1.

2.2 CENTER CONTACT: GOLD PER MIL-G-45204, TYPE II, CLASS 2

3.0 ELECTRICAL SPECIFICATIONS:

3.1 FREQUENCY RANGE: DC to 18.0 GHz

3.2 VSWR: 1.05+.01f(GHz) MAX.

3.3 INPUT POWER

0.5 WATTS AVG.

50 WATTS PEAK

3.3.1 AVERAGE INPUT POWER IS DERATED LINEARLY FROM 100% AT +25°C TO 25% AT SPECIFIED MAXIMUM AMBIENT OPERATING TEMPERATURE.

3.4 IMPEDANCE: 50 OHMS

3.5 WEIGHT: .25 Oz. MAX.

4.0 MARKING: MARK UNIT AS SHOWN (REF.: INK-09183-27-[39 or 40])

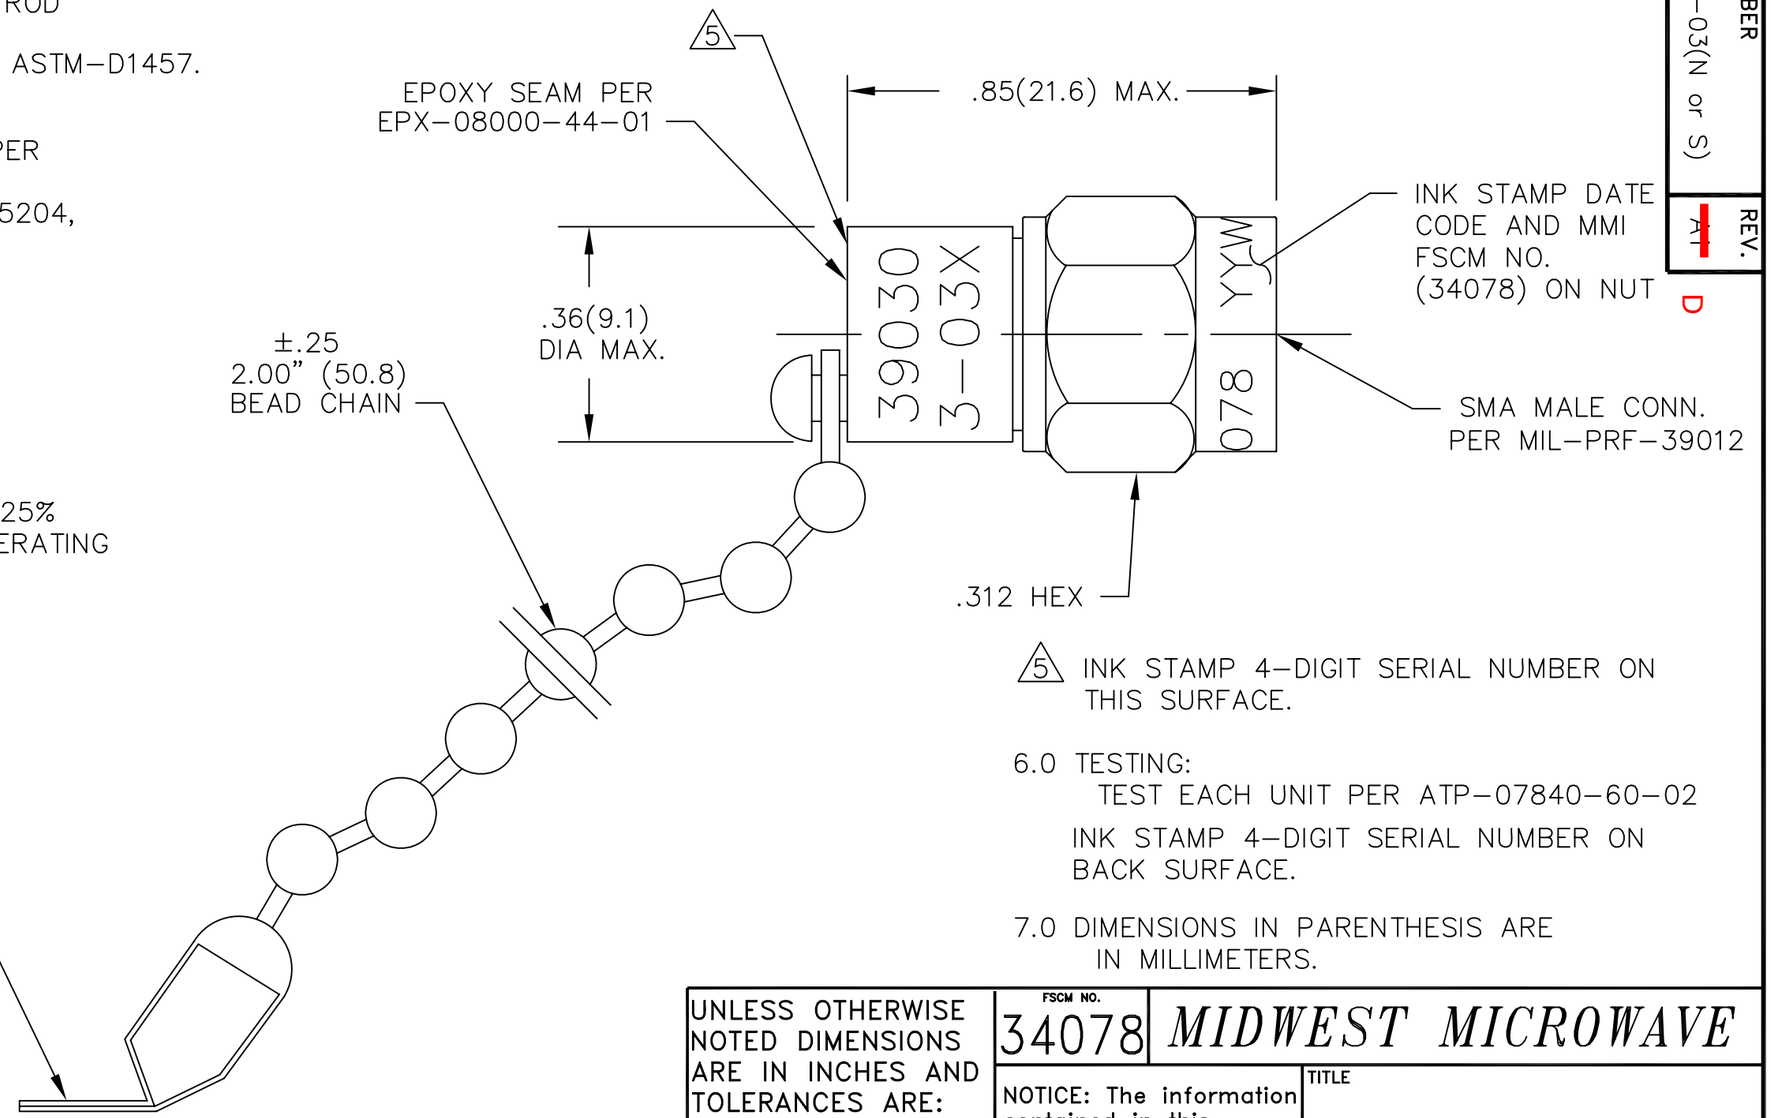


5 INK STAMP 4-DIGIT SERIAL NUMBER ON THIS SURFACE.

6.0 TESTING:

TEST EACH UNIT PER ATP-07840-60-02

INK STAMP 4-DIGIT SERIAL NUMBER ON BACK SURFACE.

7.0 DIMENSIONS IN PARENTHESIS ARE IN MILLIMETERS.

| MODEL NUMBER | REV. |
|---|---|
| M39030/3-03(N or S) | ~~A1~~ D |

| REV. | DESCRIPTION | DATE |
|---|---|---|
| – | RELEASED | 12/14/95 |
| A | ECN 15079 | 2/13/96 |
| A1 | ADDED TITLEBLOCK | 7/7/05 |
| D | ECN 21966 | 3/18/2009 |

UNLESS OTHERWISE NOTED DIMENSIONS ARE IN INCHES AND TOLERANCES ARE:

3 PLACE DECIMALS ±.005

2 PLACE DECIMALS ±.02

FRACTIONS ±1/64

PARALLELITY: T.I.R. _____

FLATNESS: T.I.R. _____

CONCENTRICITY: T.I.R. _____

ANGLES AND PERPENDICULARITY: ±1°

FSCM NO. 34078

MIDWEST MICROWAVE

NOTICE: The information contained in this drawing is proprietary and must not be used without the permission of Midwest Microwave

TITLE: TERMINATION

| DRAWN/DATE | ENG./DATE | DRAWING NUMBER |
|---|---|---|
| M.STAFFORD 11/20/95 | G.KOZAK 12/14/95 | M39030/3-03(N or S) |
| CHECKED/DATE A.BEATTY 12/1/95 | APPROVED/DATE | SCALE: 5=1 SHEET 1 of 1 |

ООО «ЛайфЭлектроникс» “LifeElectronics” LLC

ИНН 7805602321 КПП 780501001 Р/С 40702810122510004610 ФАКБ "АБСОЛЮТ БАНК" (ЗАО) в г.Санкт-Петербурге К/С 30101810900000000703 БИК 044030703

*Компания «Life Electronics» занимается поставками электронных компонентов импортного и отечественного производства от производителей и со складов крупных дистрибьюторов Европы, Америки и Азии.*

*С конца 2013 года компания активно расширяет линейку поставок компонентов по направлению коаксиальный кабель, кварцевые генераторы и конденсаторы (керамические, пленочные, электролитические), за счёт заключения дистрибьюторских договоров*

*Мы предлагаем:*

- *Конкурентоспособные цены и скидки постоянным клиентам.*
- *Специальные условия для постоянных клиентов.*
- *Подбор аналогов.*
- *Поставку компонентов в любых объемах, удовлетворяющих вашим потребностям.*

- *Приемлемые сроки поставки, возможна ускоренная поставка.*
- *Доставку товара в любую точку России и стран СНГ.*
- *Комплексную поставку.*
- *Работу по проектам и поставку образцов.*
- *Формирование склада под заказчика.*

- *Сертификаты соответствия на поставляемую продукцию (по желанию клиента).*
- *Тестирование поставляемой продукции.*
- *Поставку компонентов, требующих военную и космическую приемку.*
- *Входной контроль качества.*
- *Наличие сертификата ISO.*

*В составе нашей компании организован Конструкторский отдел, призванный помогать разработчикам, и инженерам.*

*Конструкторский отдел помогает осуществить:*

- *Регистрацию проекта у производителя компонентов.*
- *Техническую поддержку проекта.*
- *Защиту от снятия компонента с производства.*
- *Оценку стоимости проекта по компонентам.*
- *Изготовление тестовой платы монтаж и пусконаладочные работы.*

*Тел: +7 (812) 336 43 04 (многоканальный)*
*Email: org@lifeelectronics.ru*

***www.lifeelectronics.ru***